

Location Map (n.t.s.)


- NOTES:**
1. FIELD SURVEY PERFORMED BY C.R.C. & L.P.S. ON MAY 01, 2008 USING A GEODEMETER 600 PRO TOTAL STATION, A TDS DATA COLLECTOR, & A SOKKIA B21 AUTO LEVEL.
 2. WETLANDS WERE NOT DELINEATED ON THIS SITE. APPROXIMATE EDGE OF DETENTION POND AND EDGE OF STANDING WATER ARE PER DOUCET SURVEY FIELD CREW LOCATION ON MAY 01, 2008.
 3. VERTICAL DATUM BASED ON EXISTING UTILITY INVERT ELEVATIONS SHOWN ON REFERENCE PLANS BY PROVAN & LORBER, INC. DATED APRIL 2003.
 4. HORIZONTAL DATUM BASED ON ASSUMED COORDINATES.

- REFERENCE PLANS:**
1. "THE HOME DEPOT STORE #8931 COMMERCIAL DRIVE SOMERSWORTH, NEW HAMPSHIRE CHANGE BULLETN #45 GRADING & STORM SYSTEM (EROSION CONTROL)" BY PROVAN & LORBER, INC. DATED APRIL 2003
 2. "THE HOME DEPOT STORE#8931 COMMERCIAL DRIVE SOMERSWORTH, NH CHANGE BULLETN #45 UTILITY PLAN & WATERLINE EXTENSION" BY PROVAN & LORBER, INC. DATED APRIL 2003

- LEGEND**
- LIGHT POLE (ONE ARM)
 - ⊕ DRAIN MANHOLE
 - ⊙ SEWER MANHOLE
 - ⊗ RIP RAP
 - FF FINISHED FLOOR
 - STANDING WATER ELEVATIONS
x191.6'
 - CHAINLINK FENCE
 - TREE LINE
 - - - - 100' - - - - CONTOUR LINE
 - - - - DETENTION POND (SEE NOTE #2)
 - - - - EDGE OF STANDING WATER (SEE NOTE #2)
 - - - - EDGE OF DIRT
 - D - DRAIN LINE
 - S - SEWER LINE

DRAINAGE STRUCTURE TABLE

SMH #1004	RM ELEV.=193.1'
8" PVC=193.7'	
SMH #1006	RM ELEV.=200.1'
8" PVC=192.5'	
CR #1084	RM ELEV.=194.5'
24" CPP=190.5'	

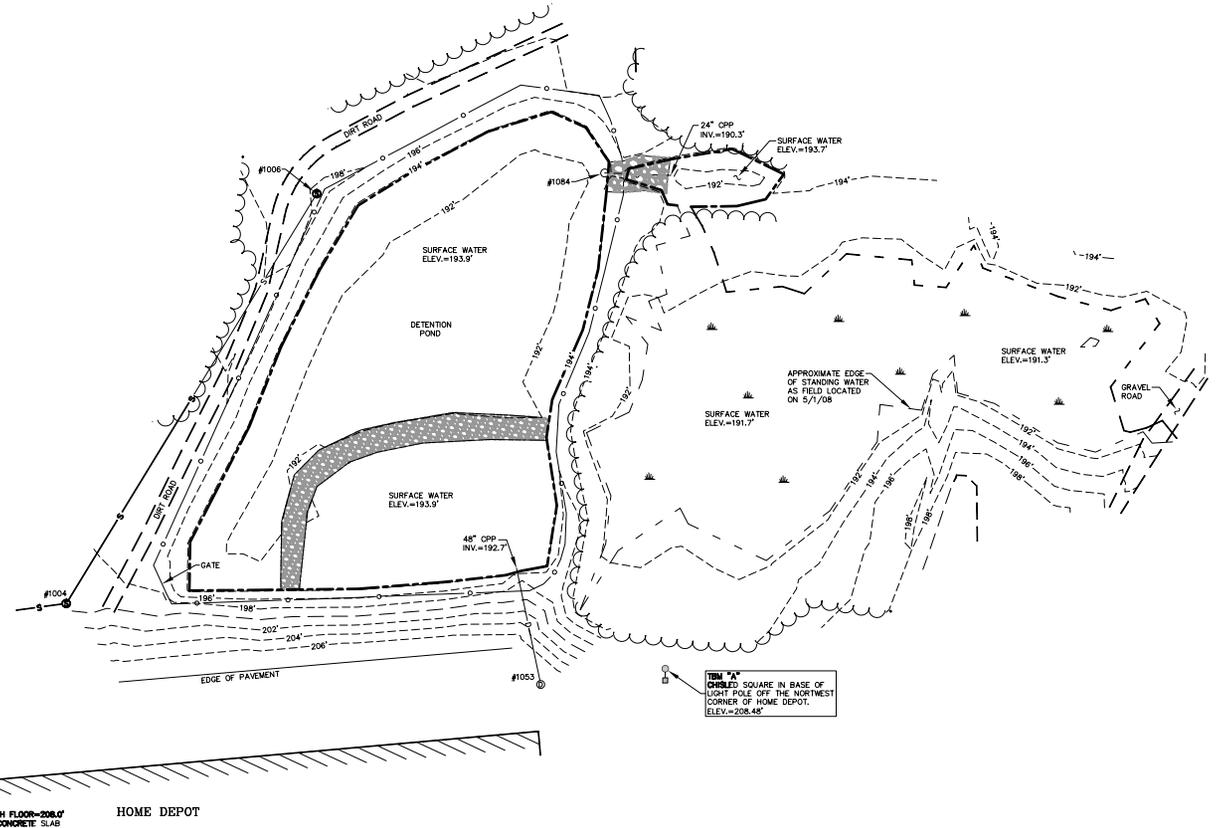


FBM "B" SQUARE IN BASE OF LIGHT POLE OFF THE NORTHWEST CORNER OF HOME DEPOT. ELEV.=208.48'

FBM "A" CHISEL SQUARE IN BASE OF LIGHT POLE OFF THE NORTHWEST CORNER OF HOME DEPOT. ELEV.=208.48'

FINISH FLOOR=208.0' ON CONCRETE SLAB HOME DEPOT

TOPOGRAPHIC PLAN
OF
HOME DEPOT DETENTION POND AREA
SOMERSWORTH, NEW HAMPSHIRE

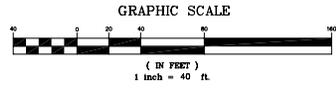

NO.	DATE	DESCRIPTION	BY

NOTE:
ALL ELECTRIC, GAS, TEL., WATER, SEWER AND DRAIN SERVICES ARE SHOWN IN SCHEMATIC FASHION, THEIR LOCATIONS ARE NOT PRECISE OR NECESSARILY ACCURATE. NO WORK WHATSOEVER SHALL BE UNDERTAKEN ON THIS SITE USING THIS PLAN TO LOCATE THE ABOVE SERVICES. CONSULT WITH THE PROPER AUTHORITIES CONCERNED WITH THE SUBJECT SERVICE LOCATIONS FOR INFORMATION REGARDING SUCH. CALL DIG-SAFE AT 1-888-805-SAFE.

DRAWN BY: L.P.S.	DATE: MAY 6, 2008
CHECKED BY: W.J.D.	DRAWING NO.: 2710A
JOB NO.: 2710	SHEET 1 OF 1

